
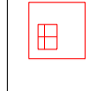
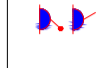









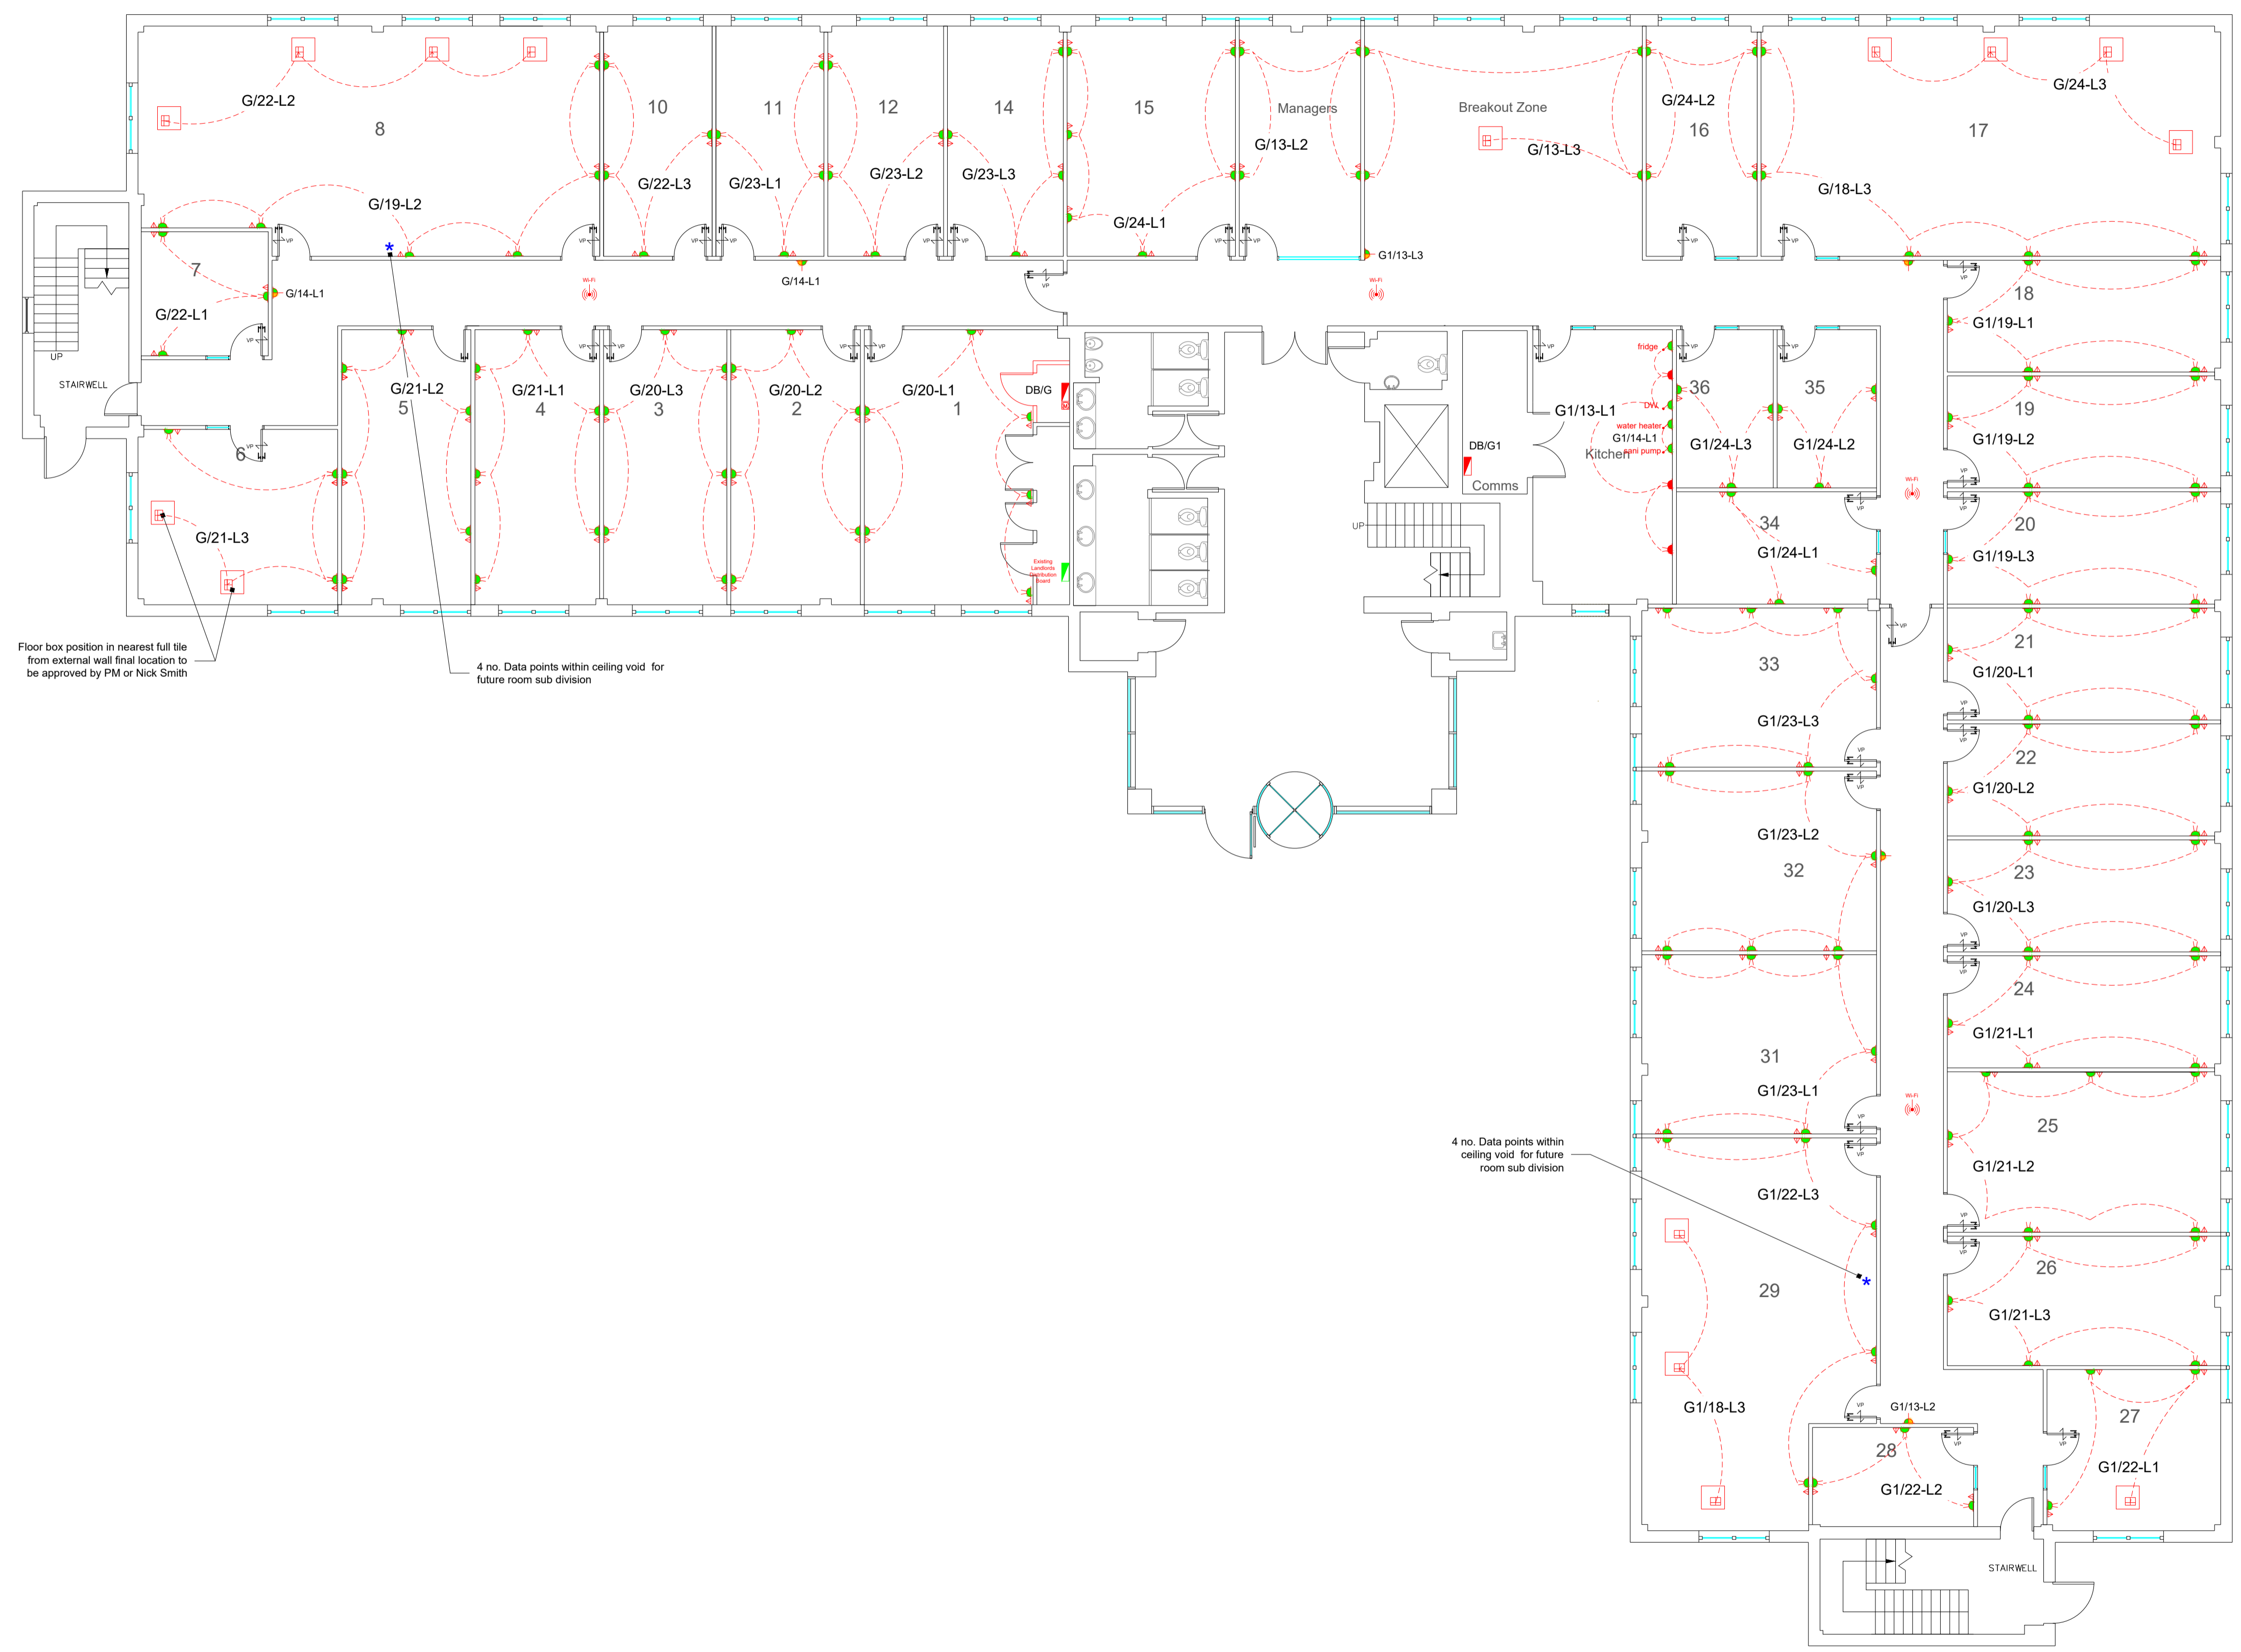


**DO NOT SCALE FROM THIS DRAWING**  
 All dimensions to be verified on site any discrepancies are to be reported in Exits Interiors before proceeding with work.  
 All area dimensions are approximate and can only be verified by a detailed survey. Any decisions to be made on the basis of area information shown on this drawing should include allowances for increases and decreases inherent in the design and building process.

NOTES:

**Key**

-  New Distribution Board
-  Floorbox with 2x DSSO & 2x data points (positioned in the nearest full tile from the perimeter wall)
-  Switched and unswitched spur at high level
-  Switched spur set @ 450ffl
-  Switched spur set mid height (to be confirmed on site)
-  DSSO set @ 450ffl
-  DSSO set above kitchen worksurface height to be confirmed on site
-  SSSO for cleaners @ 450mm fl
-  Single data plate cat 6
-  4 no. Spare Data within ceiling void (for possible future office split)
-  Perimeter wall mounted Trunking
-  Wifi Point (Position Indicative to be confirmed on site)



Floor box position in nearest full tile from external wall final location to be approved by PM or Nick Smith

4 no. Data points within ceiling void for future room sub division

4 no. Data points within ceiling void for future room sub division

REV	DESCRIPTION	DATE

CLIENT  
**BIZSPACE**

PROJECT  
**ZENITH HOUSE  
 HIGHLANDS ROAD  
 SOLIHULL**



DRAWING TITLE  
**SMALL POWER AND DATA  
 GROUND FLOOR**

STATUS  
**AS BUILT**

SCALE @ A1. DATE. DRAWN BY.  
 1:100 07/06/18 MC

DRAWING NO. Rev  
 11350/xx/12-005